

BET	ANT	ÄNDRINGEN AVSER	DATUM	SIGN
-----	-----	-----------------	-------	------

RELATIONSHANDLING



SÄRSTA 3:43
KNIVSTA


BH	Miab Förvaltning AB	018-65 67 85	018-65 67 88
A	Kilgren Arkitektkontor AB	018-10 44 30	018-69 58 11
K	Bjerking AB	018-65 11 00	018-71 04 85
VS	Vkab	018-10 04 80	018-10 04 11
V	AC installation AB / LLT	018-29 23 20	018-29 23 22
E	Bjerking	018- 65 11 00	018-14 56 05

UPPDRAGNR	RITAD/KONSTR AV	HANDLÖSARE
7084	LK	Kilgren
DATUM	ANSVARIG	
2006-01-27	GK	

Apoteksvägen 8

Plan 04

SKALA	NUMMER	BET
A1=1:100	A-40.1-0004000	
A3=1:200		

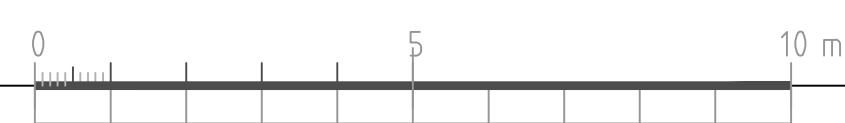

RText (RText)